


- NOTES:
1. FOR ELEVATIONS AND SECTIONS SEE DRAWING 9038-E31 AND 9038-E32.
  2. Ⓢ REFER TO BILL OF MATERIAL DRAWING 9038-E150.

NEW WORK SHOWN CIRCLED

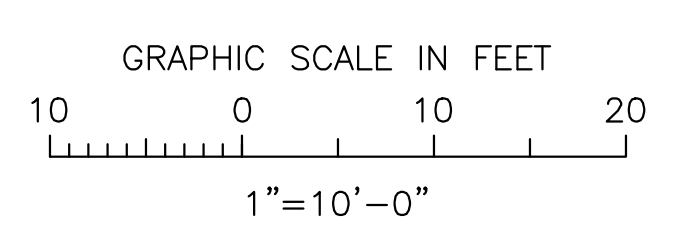

DATE			BY			NO.			REVISIONS		
12/18/98	VMM	RCG	5	AS-BUILT CONSTRUCTION - CONTRACT No. GC1-95 & No. GC1-96							
7/24/96	VMM	WPF	4	ISSUED FOR CONSTRUCTION - CONTRACT GC1-96							
1/25/96	VMM	SCM	3	ISSUED FOR BID - CONTRACT GC1-96							
6/7/95	CJP	SGM	2	ISSUED FOR CONSTRUCTION							
4/1/19	PLM	KSS	7	AS-BUILT 2019							
7/1/17	PLM	KSS	6	ISSUED FOR BID 903825-04							

DRAWN		CHKD		APPRD		DATE		SCALE		NO.	
VMM		SGM		CNM		2/21/95		1"=10'-0"		EXHIBIT F	

**PLM** ELECTRIC POWER ENGINEERING  
 35 MAIN STREET (508) 435-9377 HOPKINTON, MA 01748  
 NORTH ATTLEBOROUGH ELECTRIC DEPARTMENT  
 NORTH ATTLEBOROUGH, MASSACHUSETTS  
 E.D. SHERMAN SUBSTATION EXPANSION  
**ELECTRICAL ARRANGEMENT PLAN**